




Proposed Layout

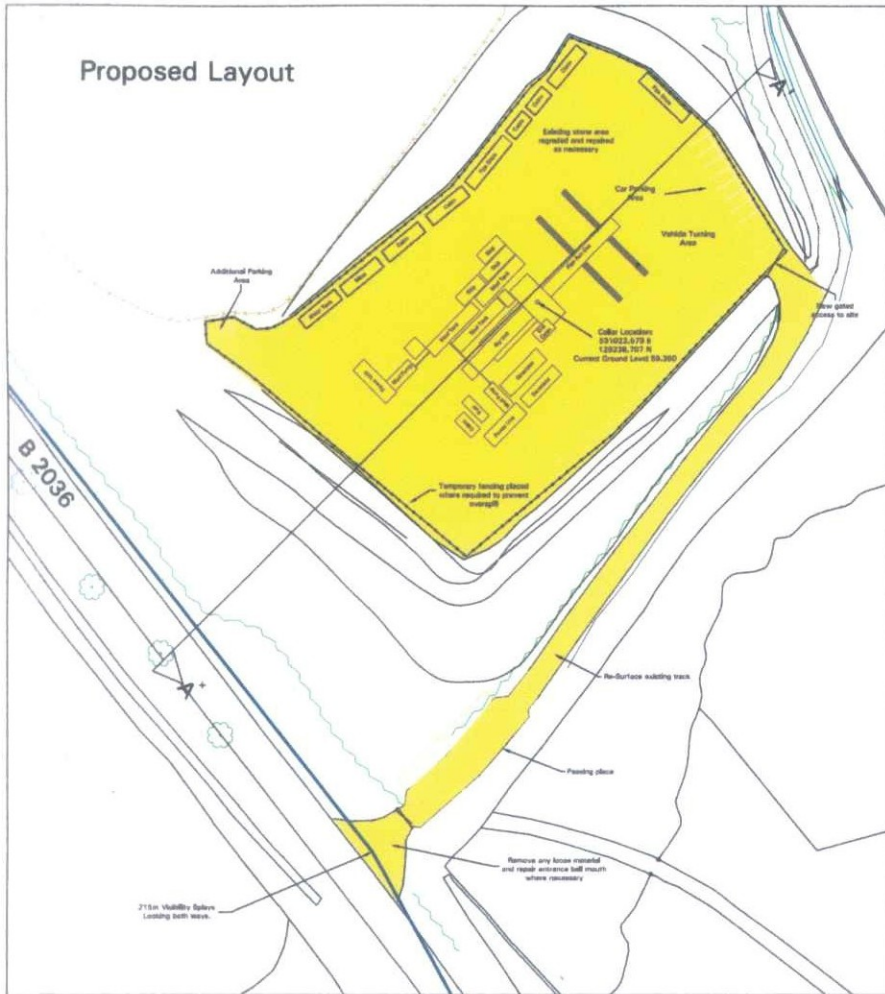

Existing Contours

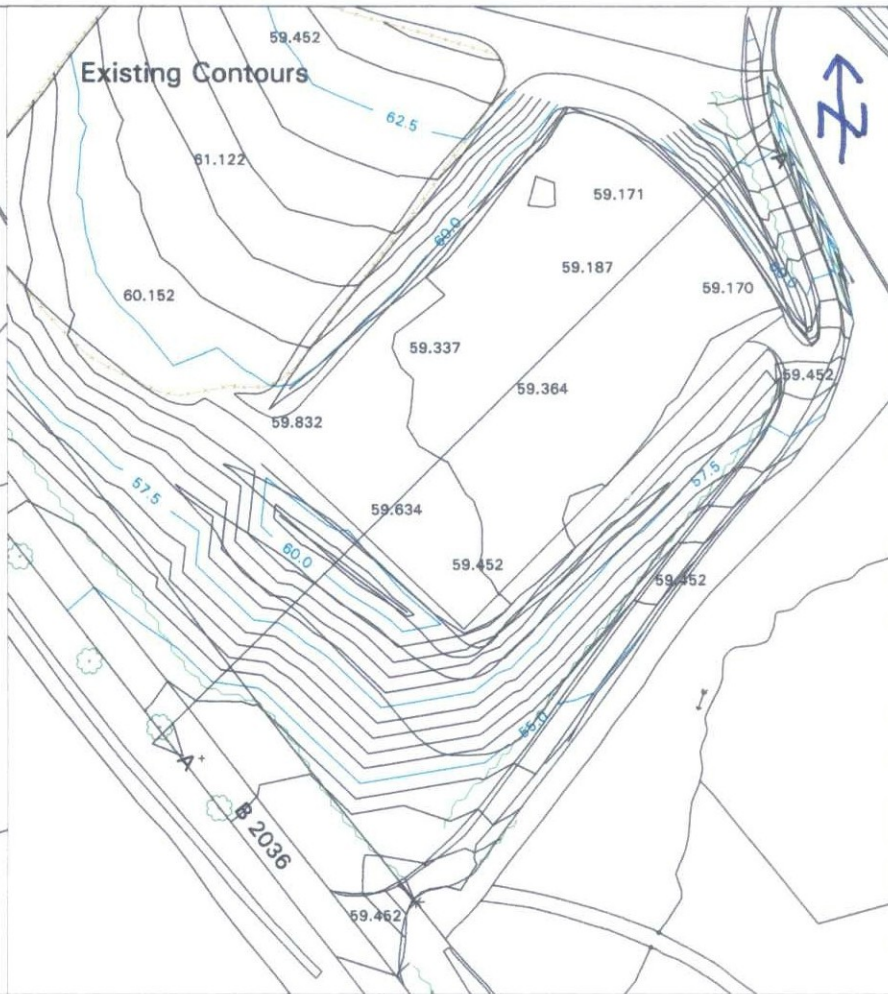

Section showing Drilling Rig

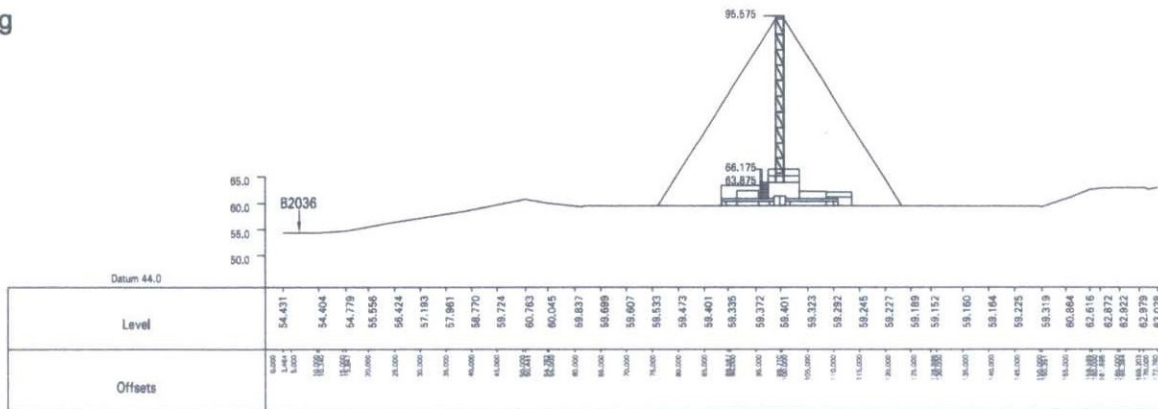

Notes:

Drawn	Dim	Iss	WS
Revised for Approval	Dim	Iss	WS
Revised for Construction	Dim	Iss	WS

Rev	Date	Amendment
A	18.01.10	Issue-As-Built

Scheme: Lower Stumble Drilling Site

Class: Cuadrilla

Drawing title: Proposed Layout W/Existing Contours And Section Through Site During Drilling Phase

Scale: 1:500 Drawing Number: CRL-001 Rev: A

Car'd	Drawn	SB	Checked	LD5	Approved	PM
82/16 (A1)	Dim	08.12.09	Dim	08.12.09	Dim	18.01.10

This drawing is the property of Fox (Overby) Ltd and must not be reproduced or passed to a third party without permission.

Fox (Overby) Ltd.
 Cooney Hall
 Market Place
 Lincolnshire
 LN9 3BU
 Tel: 01673 878444
 Fax: 01673 878444