





Appendix 1.1

NEW APPLICATION SITE BOUNDARY

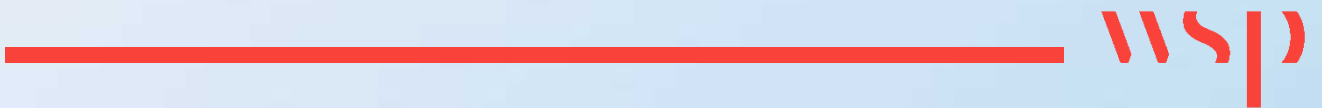

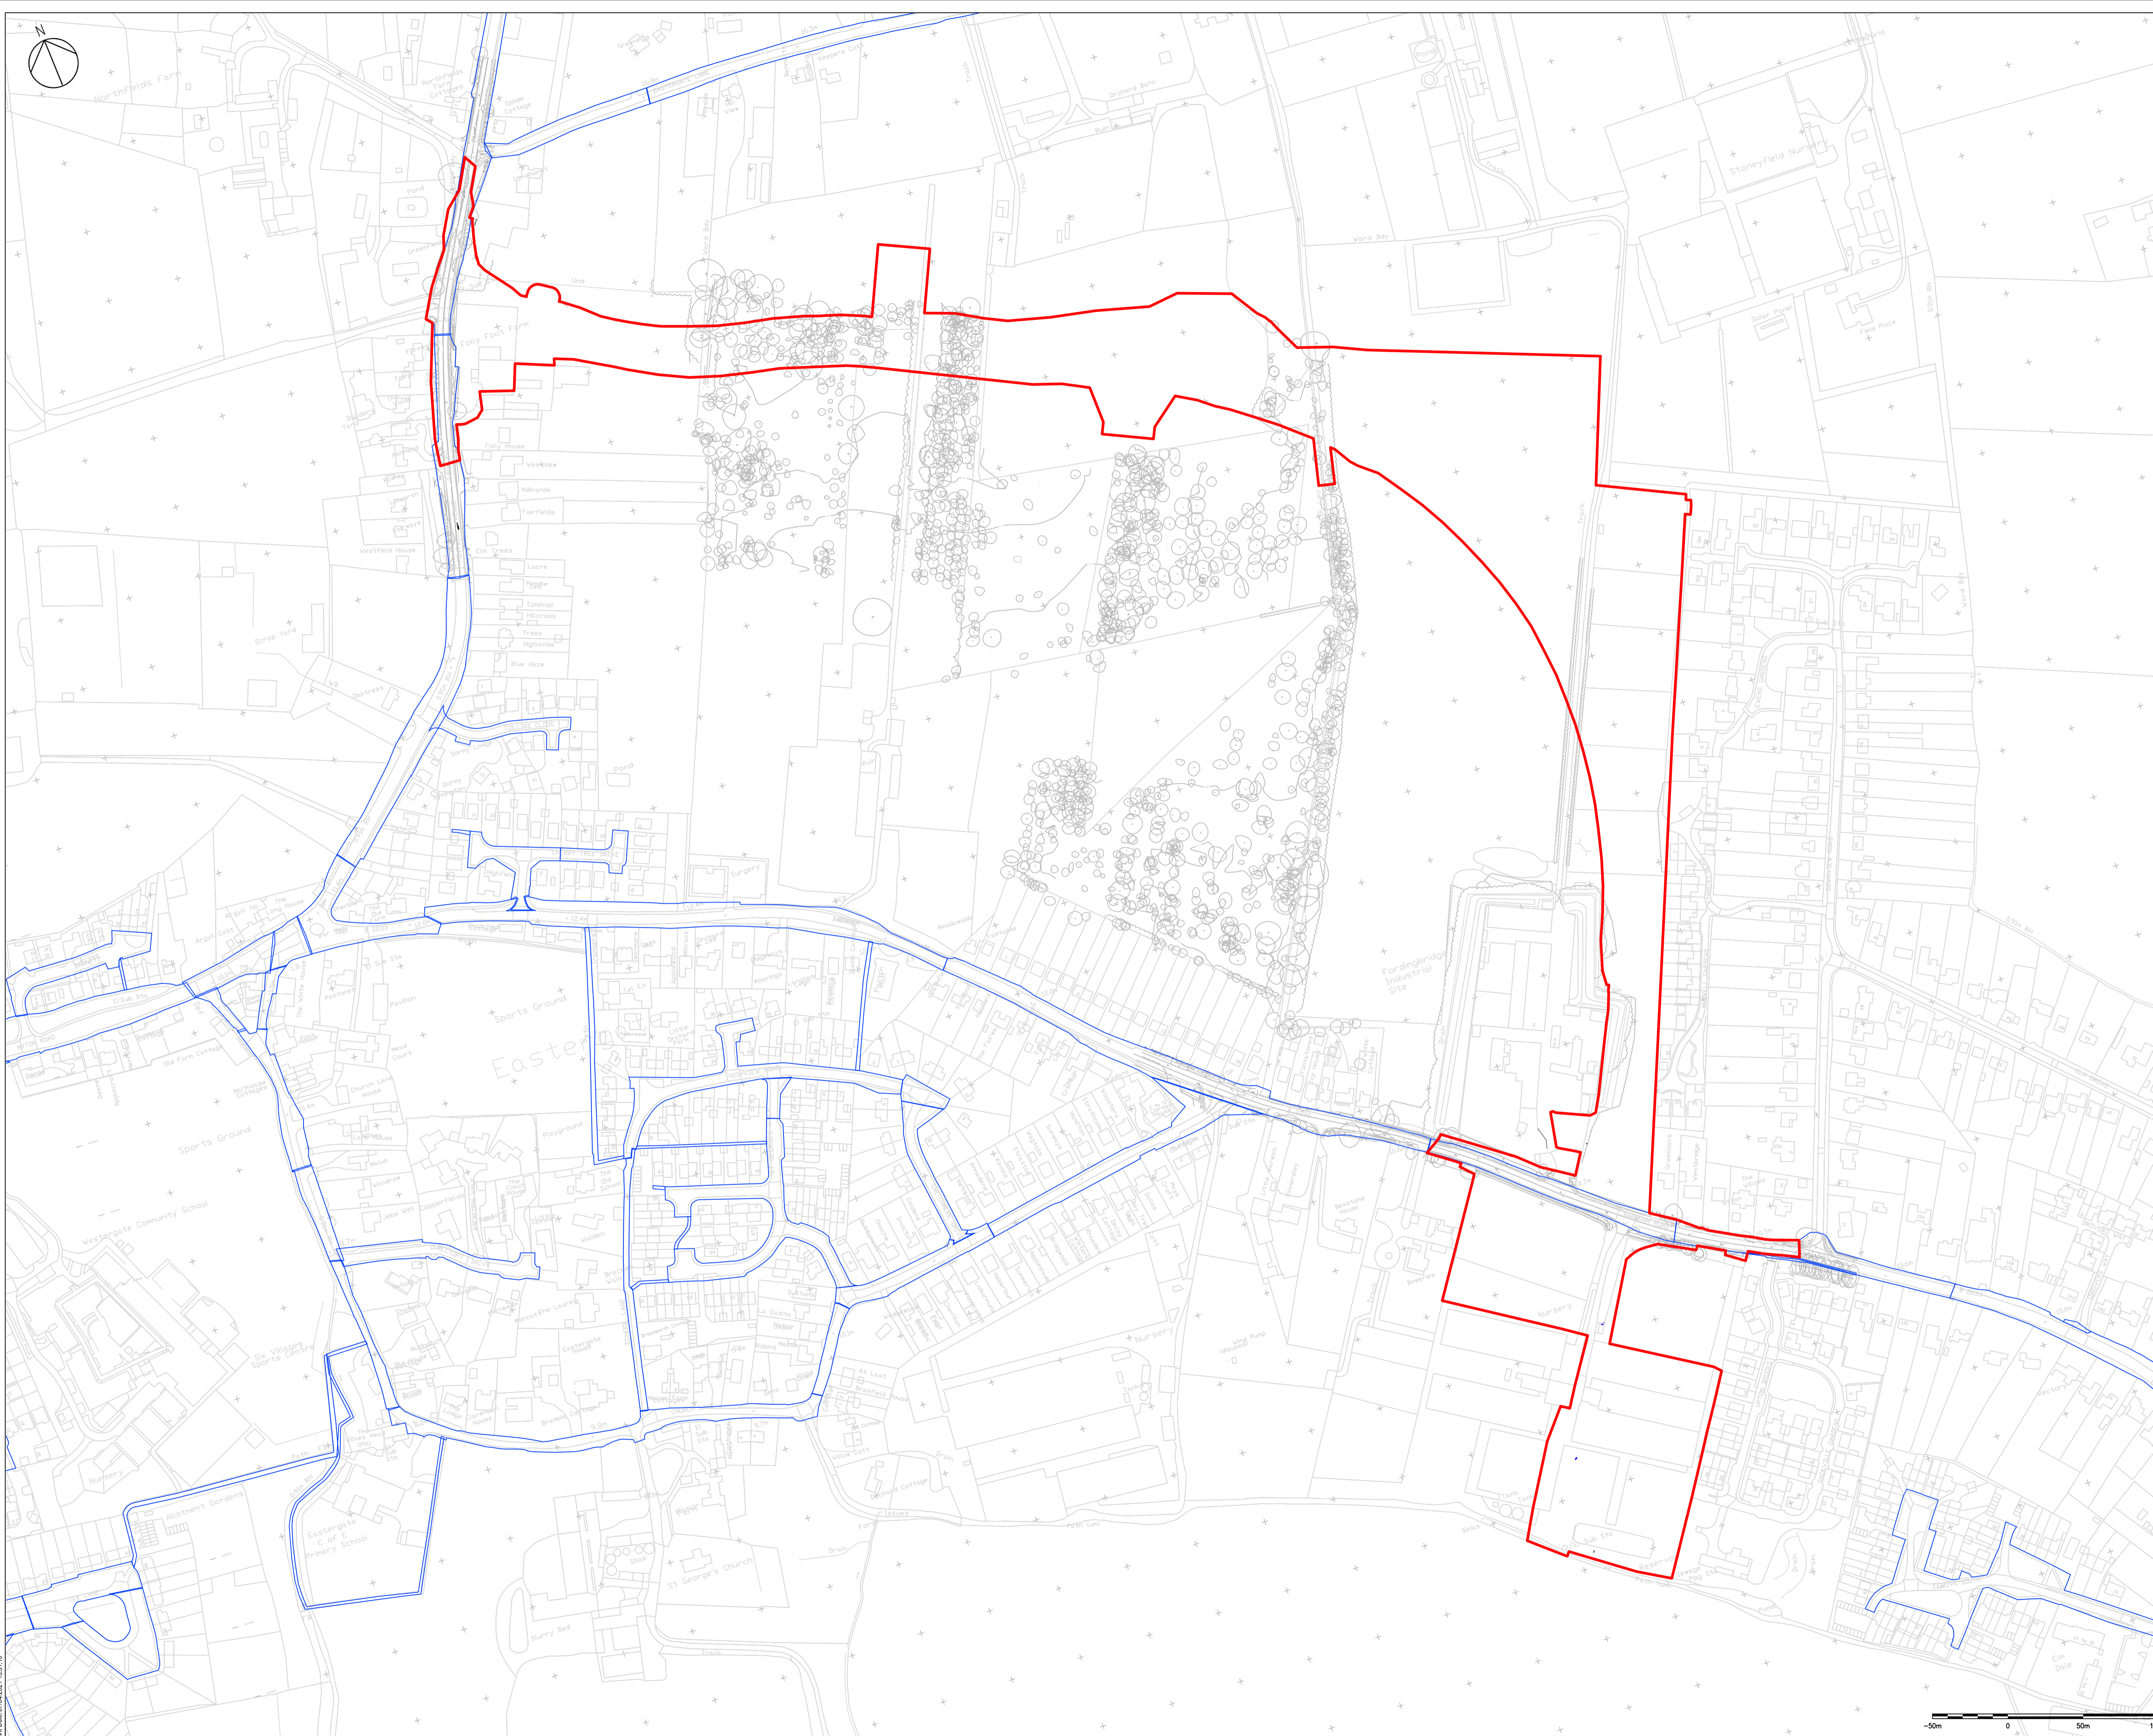

NOTES:
1. ALL DIMENSIONS ARE IN METRES UNLESS OTHERWISE STATED.

KEY
 — PROPOSED SCHEME RED LINE BOUNDARY
 — WSCC EXISTING HIGHWAY BOUNDARY AND PROPERTY OWNERSHIP BOUNDARY

Rev	Drawn	Checked	Approved	Description	Date
P05	JD	KS	AB	UPDATED RED LINE BOUNDARY	08.04.2021
P04	LR	KS	AB	HIGHWAY BOUNDARY AMENDED	21.10.2020
P03	CS	KS	AB	UPDATED RED LINE BOUNDARY	16.10.2020
P02	LR	KS	AB	UPDATED MODELS	28.08.2020
P01	LR	KS	AB	FIRST ISSUE	03.07.2020

Purpose of Issue
For Planning **S0**

Classification
Public



Project
A29 Realignment Scheme

Drawing
Site Boundary Plan

Scale @ A1	Drawn	Checked	Approved
1:1250	LR	KS	AB

Project No.	Date
CS099505	30-06-20


Drawing Identifier
 Project - Originator - Zone - Level - File Type - Role - Number
A29-CAP-HPN-00-DR-C-0174 **P05**

Capita House, Wood Street, East Grinstead, RH19 1UU
 01342 327161
 www.capitaproperty.co.uk
 Capita Property and Infrastructure Ltd.

P:\01_Docs\07242021\153118

Appendix 1.2



APPLICATION BOUNDARY CHANGES

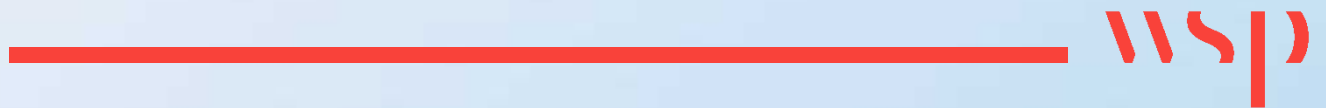




DO NOT SCALE

- NOTES:
1. ALL DIMENSIONS ARE IN METRES UNLESS OTHERWISE STATED.
 2. DO NOT SCALE, IF IN DOUBT CONTACT PROJECT MANAGER.

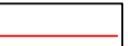- KEY:
-  Red line boundary for planning purposes
 -  Superseded red line boundary

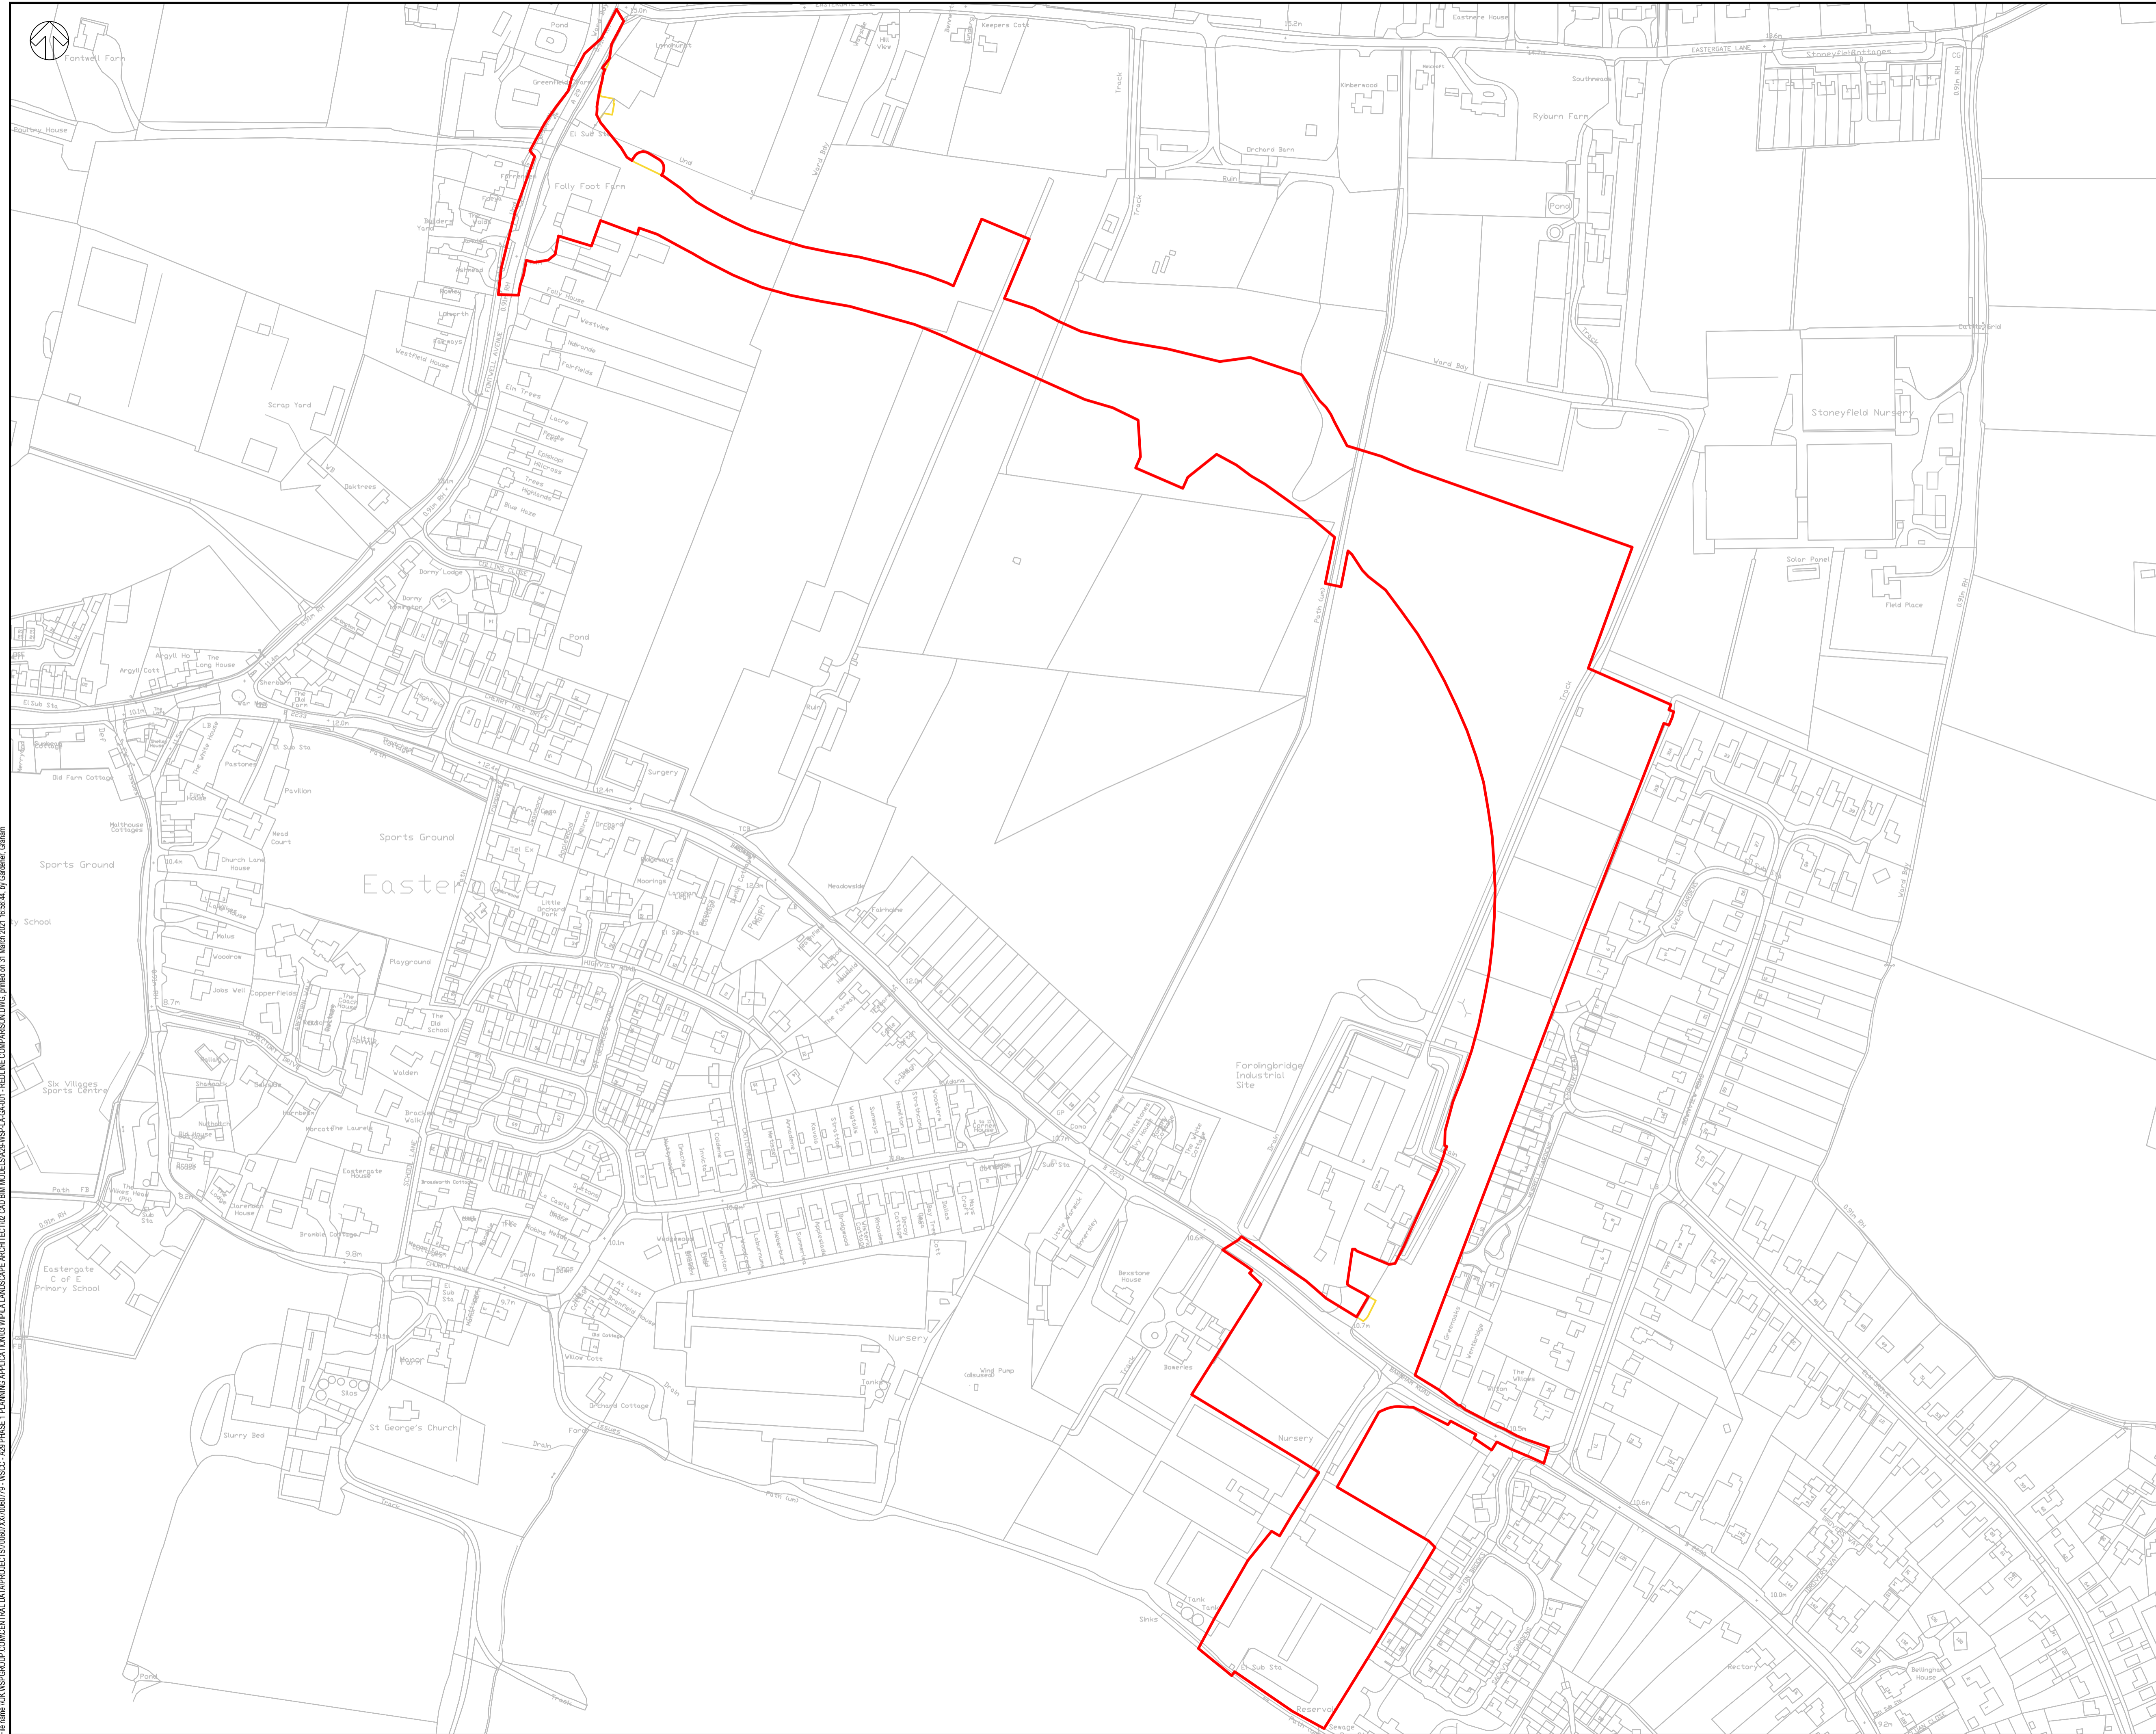

REV	DATE	BY	DESCRIPTION	CHK	APP
F	31/03/2021	GG	SIXTH ISSUE	DC	JN
E	03/03/2021	GG	FIFTH ISSUE	DC	JN
D	30/09/2020	GG	FOURTH ISSUE	DC	JN
C	30/09/2020	GG	THIRD ISSUE	--	--
B	09/09/2020	GG	SECOND ISSUE	--	--
A	19/08/2020	GG	FIRST ISSUE	--	--

DRAWING STATUS: FOR PLANNING APPLICATION



3rd Floor, Kings Orchard, 1 Queen St, Bristol, BS2 0HQ, UK
T+ 44 (0) 1179 306 200
wsp.com

CLIENT: WSCC

ARCHITECT: -

SITE/PROJECT: A29

TITLE: REDLINE BOUNDARY

SCALE @ A1: Not to scale	CHECKED: DC	APPROVED: JN
PROJECT NO: 70060779	DESIGNED: GG	DRAWN: GG
		DATE: October 20

DRAWING No: A29-WSP-LA-DRG-006

REV: F

© WSP UK Ltd

File name: \\UK\WSPGROUP\COMMON\DATA\PROJECTS\70060779\WSP\LA\A29\PHASE 1\PLANNING\APPLICATIONS\WSP\LA\A29\REDLINE\COMPARISON\DWG_001.dwg, 31 March 2021, 15:58:44, by: Gabeah, Gabeah